



Ana Barrio
Acting Commissioner

Eric C. Macfarlane, P.E.
Deputy Commissioner
Infrastructure

Shahram Jaromi, P.E.
Associate Commissioner
Construction Management

Robert Yueh, P.E.
Assistant Commissioner
Construction Management V

October 10, 2017

New York City
Department of Environmental Protection
Division of Connections: Permits
59-17 Junction Blvd.
Corona, NY 11368

Attn: Mr. Mark Safari, P.E. Chief Engineer

RE: Contract No.: HD-161D
Reconstruction of Gateway Estates Area, Phase D
Contract Reg. #20141406967

**Available Sanitary Sewers in Vandalia Avenue
Between Ashford Street and Elton Street
Transmittal No. 9**

Dear Mr. Safari,

The 10" E.S.V.P. Sanitary Sewer on Vandalia Avenue between Ashford Street and Elton Street has been installed in accordance with the D.E.P. plans and specification.

The Storm Sewer was television inspected by D.D.C. and found to be in a satisfactory condition. Consequently, the specified section along Vandalia Avenue can now be connected to the sewer, by the developer. Attached, please find a drawing of the Sanitary Sewer System with the riser's location, which is currently being accepted for flow.

Also, attached is the list of properties to be hooked-up to the Sanitary Sewer,

If you have any questions, please call at (718) 391-3161

Very truly yours,

Jatin Upadhyay
Engineer-In-Charge

C: B. Yueh
M. Brandao
J. Upadhyay
E. Akhnoukh (Permit Section)
File

October 10, 2017

Contract No.: HD-161D

Reconstruction of Gateway Estates Area, Phase D

Contract Reg. #20141406967


Sanitary Hook-Up Notice
Transmittal No. 9

List of Properties on Vandalia Avenue

No.	House No.	Street Name	Block	Lot	Can be Hooked-UP	Cannot be Hooked-Up
1	475	Vandalia Avenue	4452	290	✓	
2	479	Vandalia Avenue	4452	290	✓	
3	481	Vandalia Avenue	4452	290	✓	
4	483	Vandalia Avenue	4452	290	✓	
5	485	Vandalia Avenue	4452	290	✓	
6	487	Vandalia Avenue	4452	290	✓	
7	489	Vandalia Avenue	4452	290	✓	
8	491	Vandalia Avenue	4452	290	✓	
9	493	Vandalia Avenue	4452	290	✓	
10	495	Vandalia Avenue	4452	290	✓	
11	497	Vandalia Avenue	4452	290	✓	
12	494	Vandalia Avenue	4452	290	✓	
13	496	Vandalia Avenue	4452	290	✓	
14	498	Vandalia Avenue	4452	290	✓	
15	500	Vandalia Avenue	4452	290	✓	
16	502	Vandalia Avenue	4452	290	✓	
17	504	Vandalia Avenue	4452	290	✓	
18	506	Vandalia Avenue	4452	290	✓	
19	508	Vandalia Avenue	4452	290	✓	
20	510	Vandalia Avenue	4452	290	✓	

*✓ Can be Hooked-Up

✗ Cannot be Hooked-Up

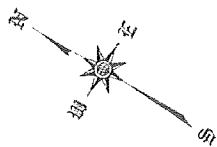

**LOWER
ASHFORD STREET**

**SEE SHEET 5
For Ashford St**

LEGEND

Existing

SAN, SWR Less than 24"

SAN. SWR Greater than 24"

Manholes

Needs to be installed

Manholes

SWR

Recon. of Gateway Estates, Phase D

CONTRACT NO: HD-161D

REG NO: 20141406967


Sanitary Flow Distribution

October 10, 2017

Sheet: 13


3 of 4

ELTON ST

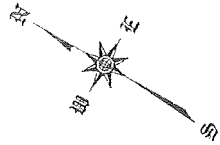


BUILDING LINE

10'

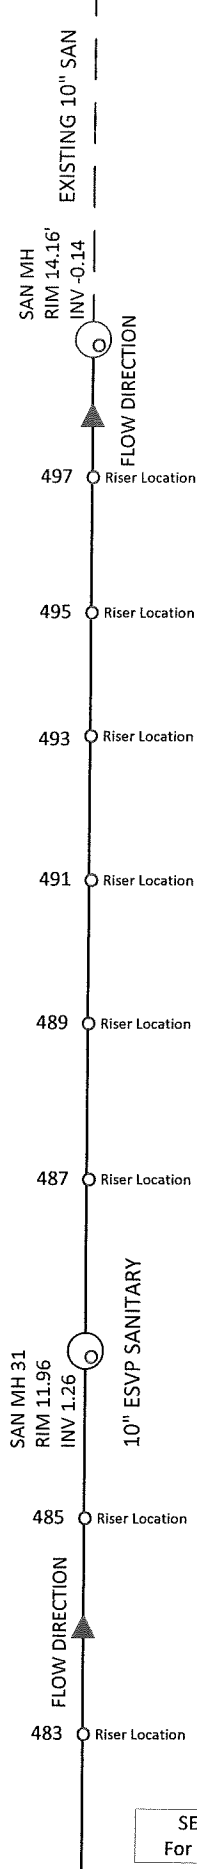

SEE SHEET 13
For Vandalia Ave

VANDALIA AVENUE

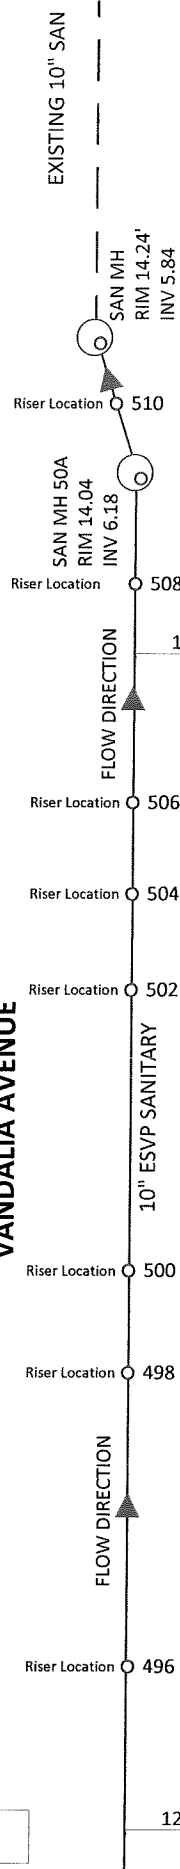


10'

BUILDING LINE

4 of 4

LEGEND

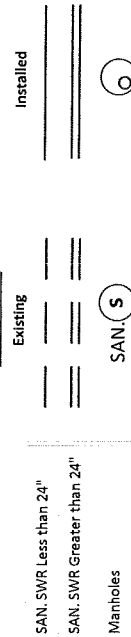

Recon. of Gateway Estates, Phase D

CONTRACT NO: HD-161D

REG NO: 20141406967

Sanitary Flow Distribution

October 10, 2017

Sheet: 14

* General numbers assigned to houses currently not numbered



SCALE: NTS

NEHEMIAH 4 - SITE PLAN 06-07-2016

Locations That Can Accept Flow & Have Correct House Numbers